

HIGHWAYS ACT 1980

SEFTON METROPOLITAN BOROUGH COUNCIL

(M58 JUNCTION 1 IMPROVEMENTS)

(SIDE ROADS) ORDER 2018

Sefton Metropolitan Borough Council ("the Council") makes this Order in exercise of its powers under sections 14 and 125 of the Highways Act 1980 and all other powers enabling them in that behalf;

1. The Council is authorised in relation to the Classified Road ^{at sefton} and ~~Unclassified Road~~ in the Borough of Sefton to;

1.1 ^{cjm Metropolitan} stop up each length of highway named in Schedule 1 and shown on the corresponding Site Plan by zebra hatching.

1.2 stop up each private means of access to premises described in Schedule 2 and shown on the corresponding Site Plan by a solid back band; and

1.3 provide new means of access to premises shown on the corresponding Site Plan by thin diagonal hatching

^{cjm}
~~2.~~ 3. Where immediately before a length of highways is stopped up in pursuance of this Order there is under, in, on, over, or along that highway any apparatus of statutory undertakers or any telecommunications code system operator, as the case may be, shall continue to have the same rights as respects that apparatus as they had immediately before the stopping up took place.

^{cjm}
~~3.~~ 4. In this Order; then subject to section 21 of the Highways Act 1980, those undertakers, or that operator,

^{cjm}
~~3.1~~ 4.1 distances are measured along the route of the relevant highway or private means of access, as the case may be; and

^{cjm}
~~3.2~~ 4.2 a reference to a Schedule or Site Plan number is a reference to the Schedule or Site Plan, so numbered.

^{cjm}
"the classified road" means the A506 between its junction with Prescott Road in the south east and its junction with the M58 motorway, which is classified in accordance with Section 12 of the Highways Act 1980

^{cjm}
2. The Site Plan shows the works indicated in the said Schedule and the route of the classified road in relation to those works.

CJM	"The Council"	means the Sefton Metropolitan Borough Council;
CJM	"New Access"	means a means of access to premises authorised by this Order to be provided;
	"Schedule"	means a Schedule to this Order and "Schedules" shall be construed accordingly; CJM
	"Site Plan"	means the plan marked "Sefton Metropolitan Borough Council (M58 junction 1 Improvements) (Side Roads) Order 2018 Plan", sealed with the Common Seal of the Council and deposited in the offices of Sefton Borough Council, Magdalene House, Trinity Road, Bootle, L20 3NJ.

The Order may be cited as The Sefton Metropolitan Borough Council (M58 junction 1 Improvements) (Side Roads) Order 2018. CJM

SCHEDULE 1: LENGTHS OF HIGHWAY TO BE STOPPED UP

Giddygate Lane, between a point 16m north of the midpoint of the access to Guest Farm and the end of the adopted highway situated 55m north of the midpoint of the access to Guest Farm, being a distance of 39 metres. CJM

SCHEDULE 2: PRIVATE MEANS OF ACCESS TO BE STOPPED UP

Access to premises known as Guest Farm, along Giddygate Lane from, the A506 Maghull Lane to a point 55m north of the midpoint of the access to Guest Farm.

THE COMMON SEAL OF
SEFTON METROPOLITAN BOROUGH COUNCIL

Was hereunto affixed
And this Order thereby executed
As a Deed in the presence of

Authorised signatory



Dated this

Day of 6th February 2018



1001879



© Crown copyright and database rights
2014 Ordnance Survey 100018192.

KEY:

- HIGHWAY TO BE STOPPED UP
- PRIVATE MEANS OF ACCESS TO BE STOPPED UP
- ROUTE OF NEW PRIVATE MEANS OF ACCESS
- CLASSIFIED ROAD - CARRIAGEWAY
- CLASSIFIED ROAD - HIGHWAY BOUNDARY

COM

This Plan Drawing No M58J1-ATK-HSR-ZZ-SK-D-0002
Revision P04 replaces the attached Plan Drawing No
M58J1-ATK-HSR-ZZ-SK-D-0002 Revision P03 by
modification by the Secretary of State for Transport upon
confirmation of the Order by him

Rev.	Date	Description	Orig	Chkd	App'd	Aur'd
P01	17/10/17	SIDE ROAD ORDERS	NH	JD	JWS	JWS
P02	18/10/17	SIDE ROAD ORDERS	JO	JWS	LE	LE
P03	07/12/17	UPDATED FOLLOWING CLIENT COMMENTS	NH	JD	JWS	JWS
P04	29/06/18	UPDATED FOLLOWING CLIENT COMMENTS	NH	JD	JWS	JWS

FOR REVIEW AND COMMENT

ATKINS

Chadwick House
Birchwood Park
Warrington
WA3 6AE


Tel: +44 (0)1925 238000
Fax: +44 (0)1925 238500
www.atkinsglobal.com

Copyright © Atkins Limited (2017)


Design Status: S3		Project Title: M58 JUNCTION 1 D&B	
Drawing Title: SEFTON METROPOLITAN BOROUGH COUNCIL (M58 JUNCTION 1 IMPROVEMENTS) (SIDE ROADS) ORDER 2018			
Scale: 1:1000	Originator: NHP	Checked: JO	Approved: JWS
Original Size: A3	Date: 29.06.18	Date: 29.06.18	Date: 29.06.18
Drawing Number: M58J1 - ATK - HSR - ZZ - SK - D - 0002		Project Ref. No: 5149980	
Revision: P04		Authorised: JWS	

100
Millimetres

10
0
DO NOT SCALE

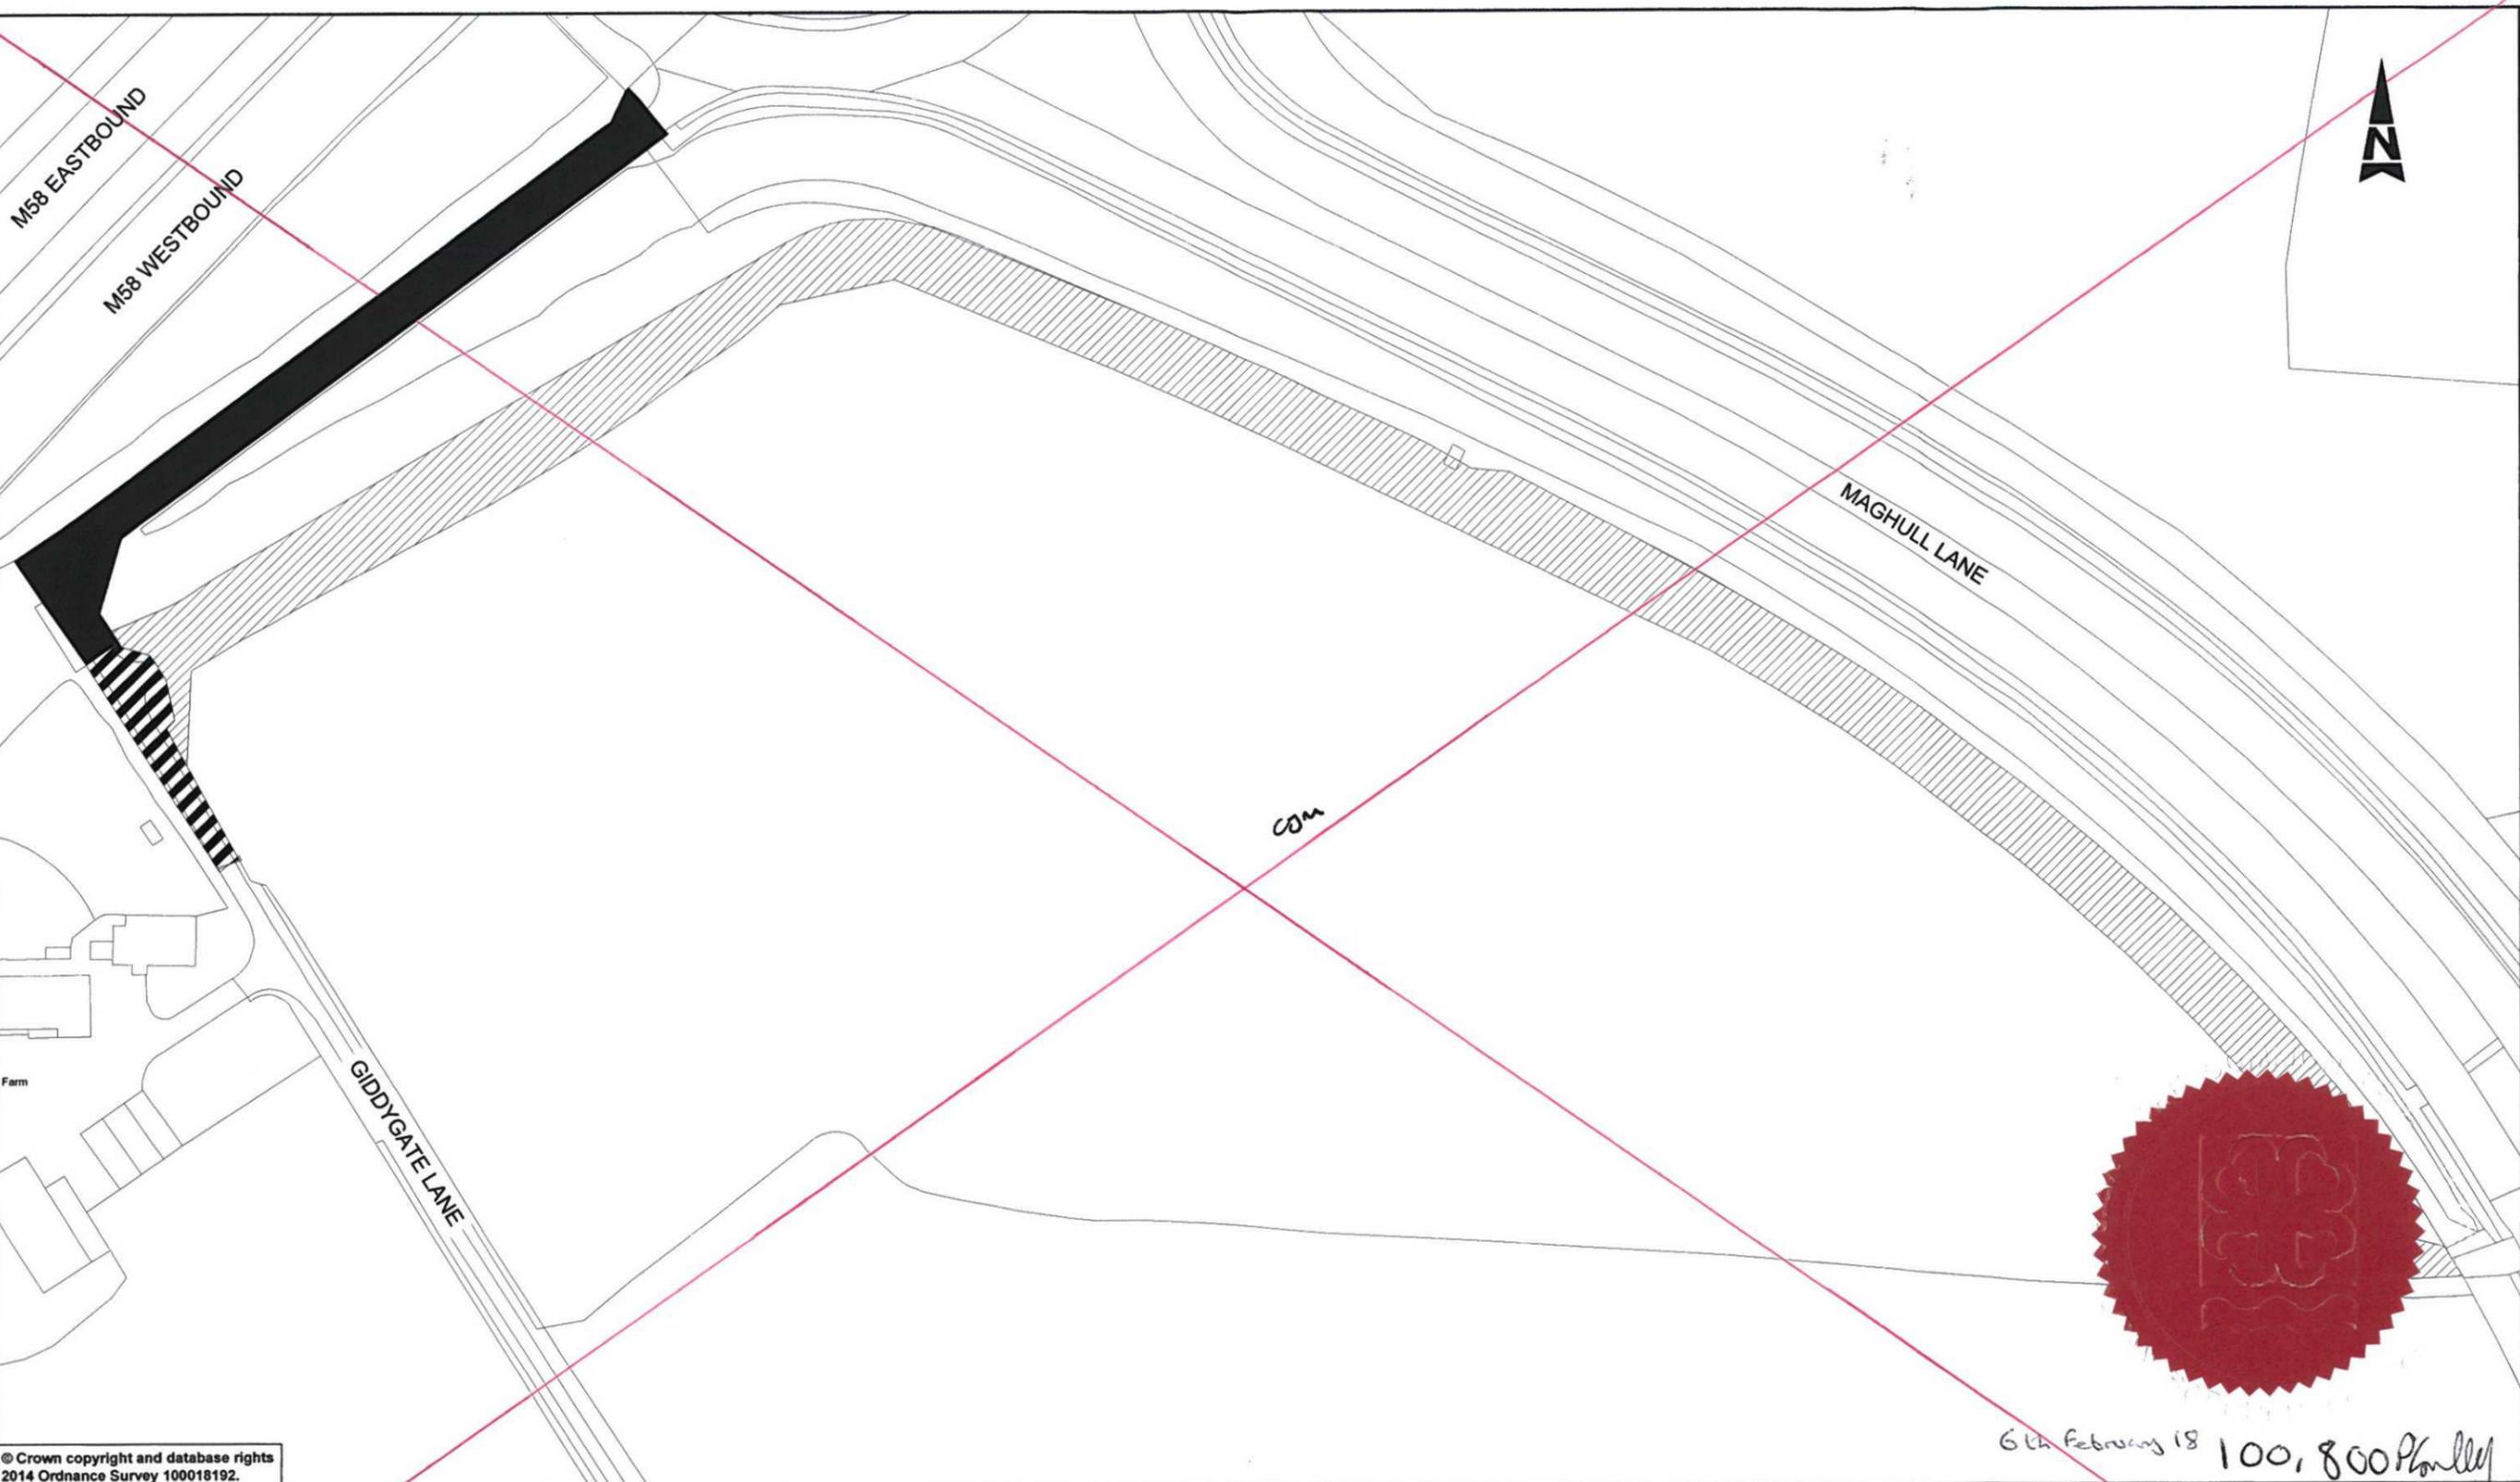

© Crown copyright and database rights
2014 Ordnance Survey 100018192.

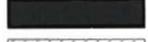- KEY:**
-  HIGHWAY TO BE STOPPED UP
 -  PRIVATE MEANS OF ACCESS TO BE STOPPED UP
 -  ROUTE OF NEW PRIVATE MEANS OF ACCESS

com

This Plan Drawing No M58J1-ATK-HSR-ZZ-SK-D-0002
Revision P03 is replaced by the attached Plan Drawing No
M58J1-ATK-HSR-ZZ-SK-D-0002 Revision P04 by
Modification by the Secretary of State for Transport upon
confirmation of the Order by him

Rev.	Date	Description	Org	CHK	App'd	Aut'd
P01	17/10/17	SIDE ROAD ORDERS	NH	JO	JWS	JWS
P02	18/10/17	SIDE ROAD ORDERS	JO	JWS	LE	LE
P03	07/12/17	UPDATED FOLLOWING CLIENT COMMENTS	NH	JO	JWS	JWS

FOR REVIEW AND COMMENT

ATKINS

Chadwick House
Birchwood Park
Warrington
WA3 6AE

Tel: +44 (0)1925 238000
Fax: +44 (0)1925 238500
www.atkinsglobal.com

Copyright © Atkins Limited (2017)

Sefton Council

SISK

Project Title	M58 JUNCTION 1 D&B				
Drawing Title	SEFTON BOROUGH COUNCIL (M58 JUNCTION 1 IMPROVEMENTS) (SIDE ROADS) ORDER 2018				
Scale	1:1000	Originator	Checked	Approved	Authorised
Original Size	A3	Date	Date	Date	Date
Drawing Number	Project	Originator	Volume	Revision	Project Ref. No.
		M58J1 - ATK - HSR - ZZ - SK - D - 0002			5149980
Location	Type	Rate	Number		
					P03

6th February 18 100,800 P/hour

**SEFTON METROPOLITAN BOROUGH COUNCIL
(M58 JUNCTION 1 IMPROVEMENTS) (SIDE ROADS) ORDER 2018**

The Secretary of State for Transport hereby confirms the foregoing Order with modifications shown by the red ink alterations which have been made to the text of the Order and to the Site Plan referred to therein and which bear the initials of the person whose signature appears below. The Secretary of State is satisfied -

- (a) as respects each highway the stopping up of which is authorised by the Order, that another reasonably convenient route is available or will be provided before that highway is stopped up, and
- (b) as respects each private means of access the stopping up of which is authorised by the Order, that other reasonably convenient means of access to the relevant premises are available or will be provided in pursuance of the Order before that private means of access is stopped up or that no access to the relevant premises is reasonably required.



CJ MILLER
A senior civil servant in the
Department for Transport

Signed by Authority
of the Secretary of State
16th August 2018